


①

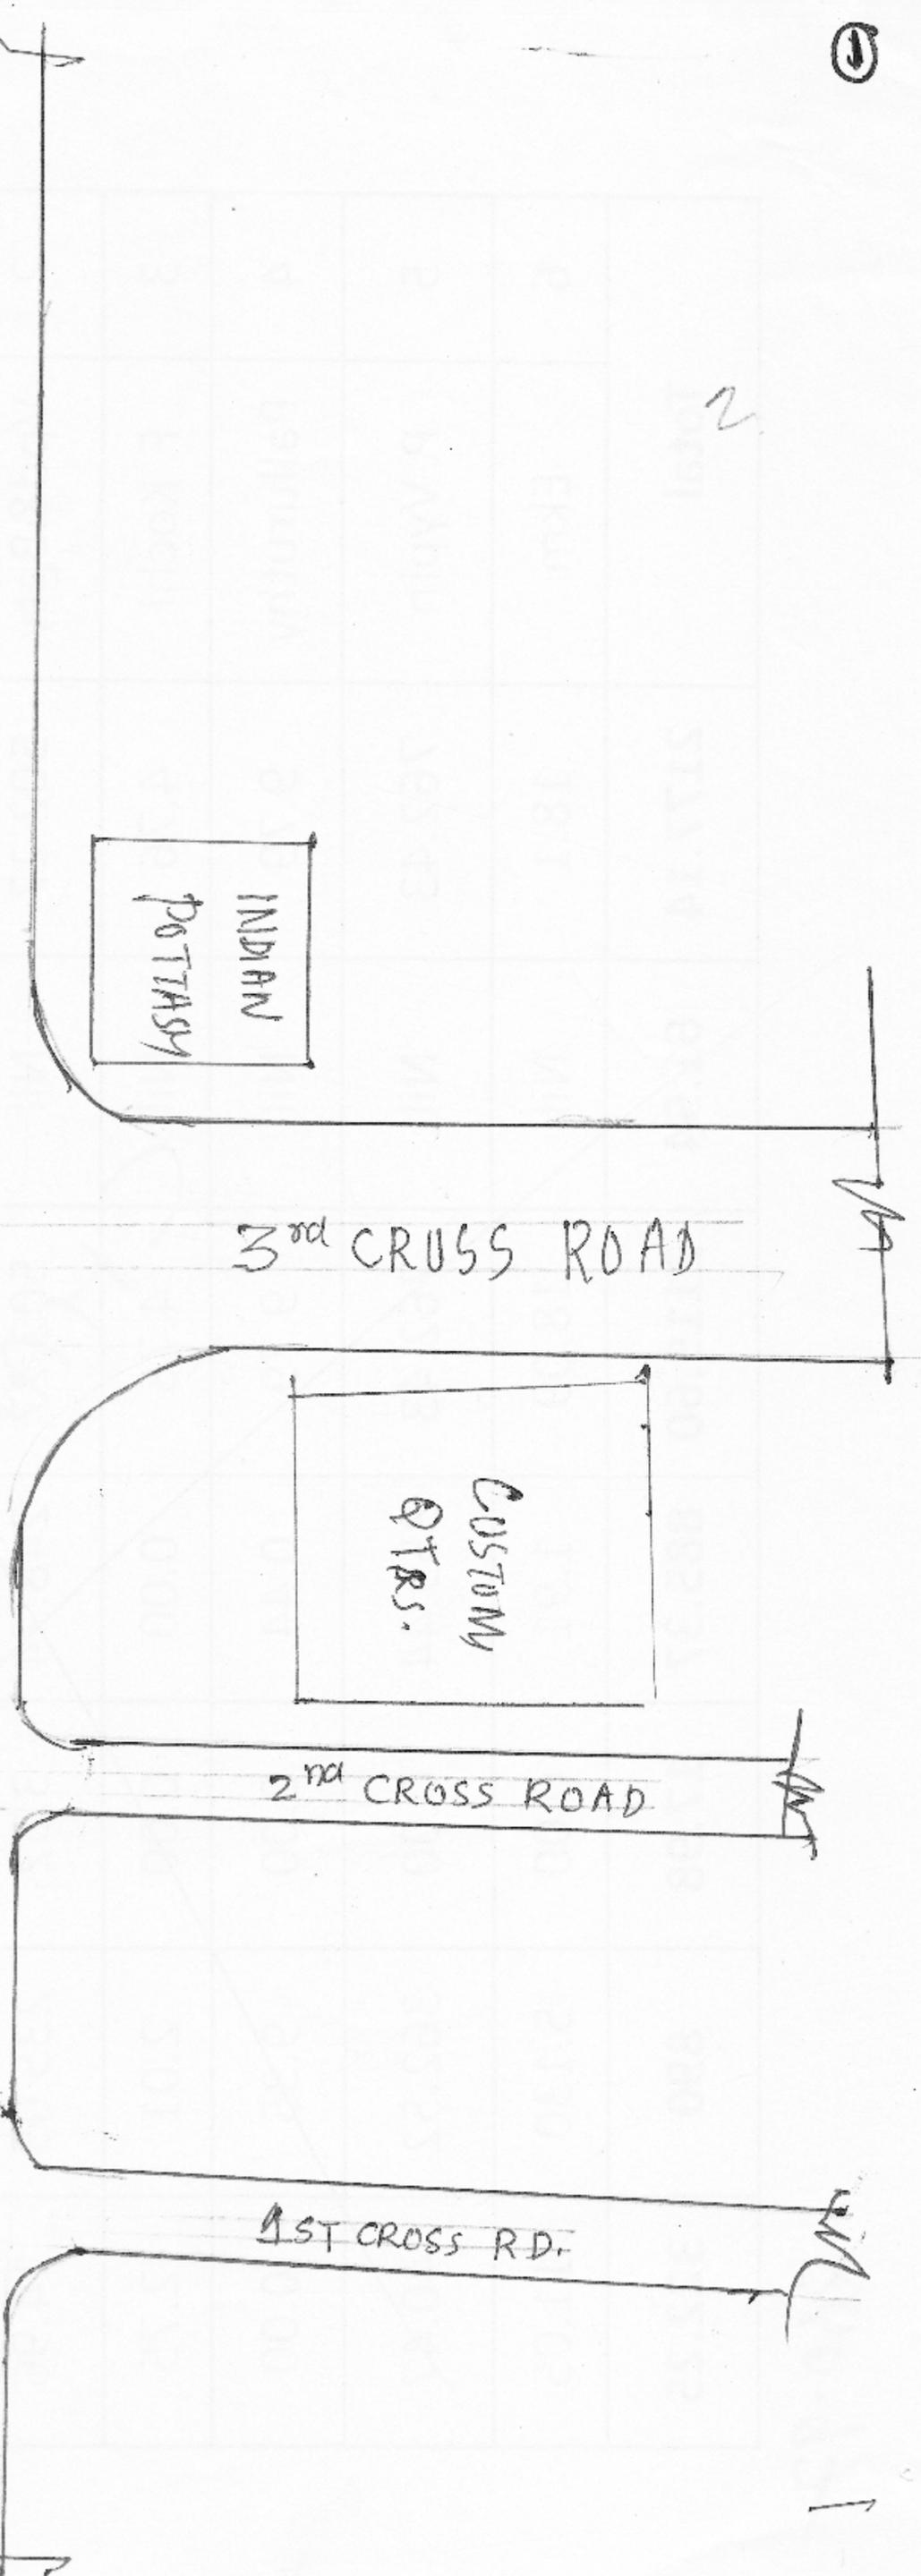

①

TO ERNY
MILNIE ROAD
TO BOAT JETTY

INDIAN
POTASHY

3rd CROSS ROAD

CUSTOMY
QTRS.

2nd CROSS ROAD

1ST CROSS R.D.

MLR B/10
MLR B/08
MLR B/06
MLR B/01


Location Sketch,
NOT TO SCALE

28/06/00
AEC/C

TO BOAT JETTY

MLR S/03
MLR S/02

will

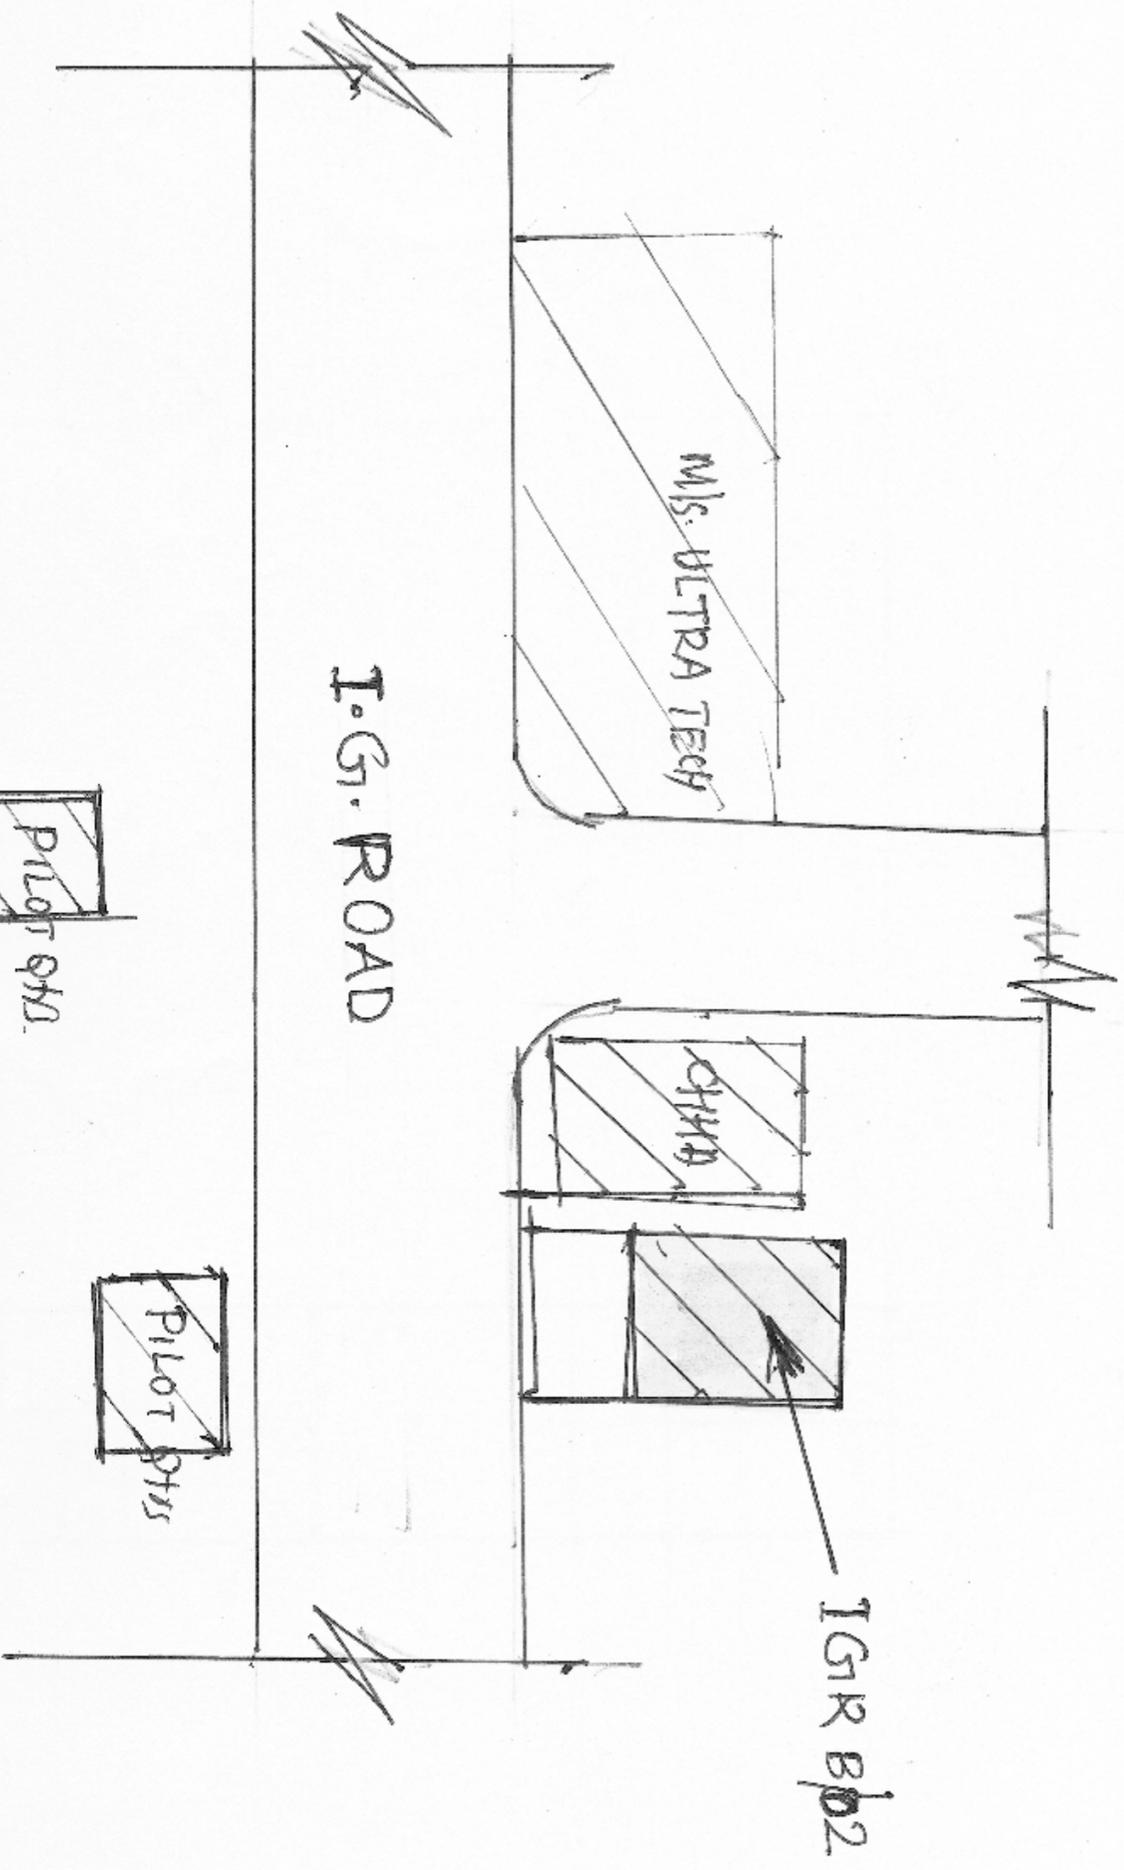


Handwritten signature or initials, possibly "S.P.C." or similar.

Location sketch,
Not to scale




~~APR 20~~
~~ABEC~~

TO N. END ← I. GI. ROAD → TO M. HALT

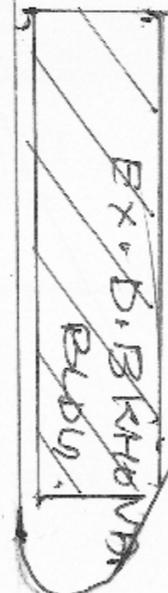

SUBRAMANIAN ROAD

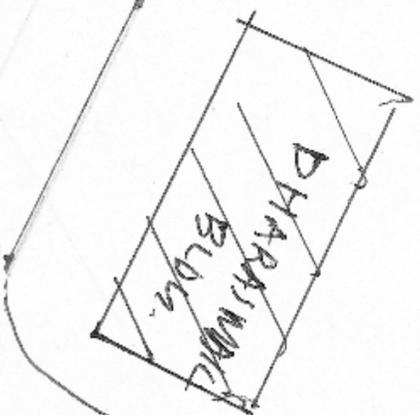


S. CROSS ROAD



Location sketch
NOT TO SCALE

(4)

FKM
W H H H H

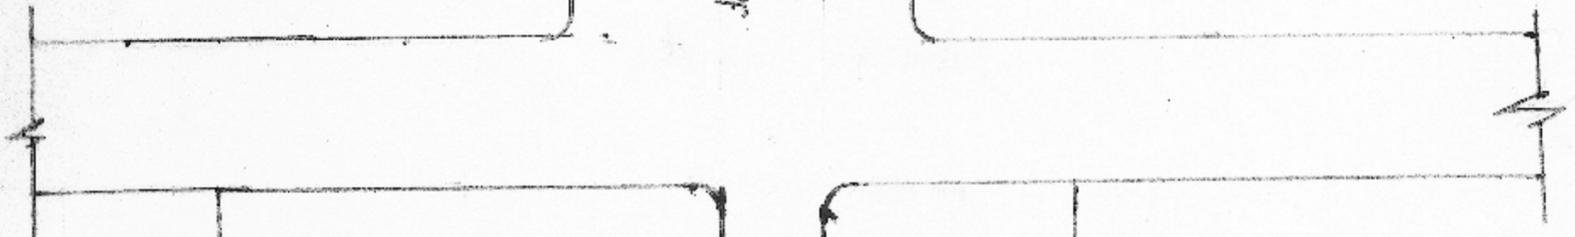

MALABAR
CEMENT

ANJERI

MALABAR
CEMENT

TATA

BRISTOW ROAD

PENNA CEMENT

VACANT


PARRY AGRO

STANES

BR/B01



5th CROSS ROAD

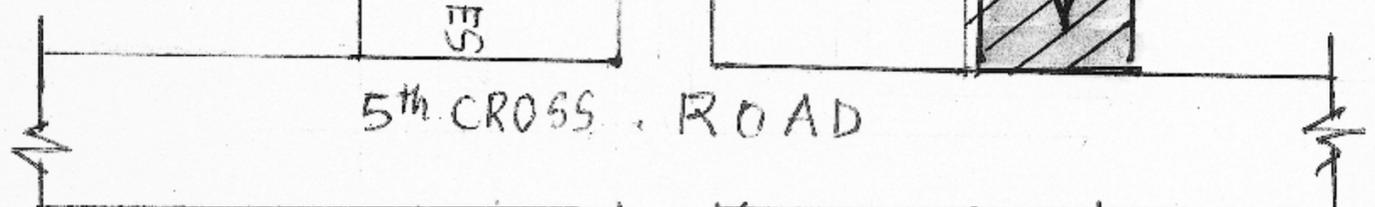

POTHAN
DEVILSX
SOVS

INDIAN
CHAMBER
OF COMMERCE



(5)

(7)



5

PARKING YARD

BRISTOW SCHOOL

ACHUTAN PILLAI & SONS

BPR/603

MALABACEMEN ROAD

KERALA STATE CO-OPERATIVE FEDERATION
VACANT LAND
KATA

5th CROSS ROAD

GR. V. IYYAR ROAD

POTHEM DEYASSY & SONS
INDIAN CHAMBER OF COMMERCE
PAULAB RD
MERCANTILE MARINE
AMBAL WARE HOUSE
UKO BANK
PILMEN BLDG (BANK OF INDIA)
PILMEN BLDG
CIVIL OFFICE CLERK
ELLIXER BLDG
INDIAN BANK
AIR LINKS
INTUC

6th CROSS ROAD

BPR/602
VACANT
BPR/603
HARI SON MALA
MOLTA

BRISTOW ROAD

CORPUS KSEO ST
PARISON GODOWN
DAREASH MAIL

5th CROSS ROAD



TRANSWORLD HOUSE
FORBIS

A.V.T
AMILSAM
J. TOMAS & COMPANY
R.B.T
VEERA TRADERS


HARISON MALAYALAM

TRAINING INSTITUTE

Handwritten signature or initials in a circle.

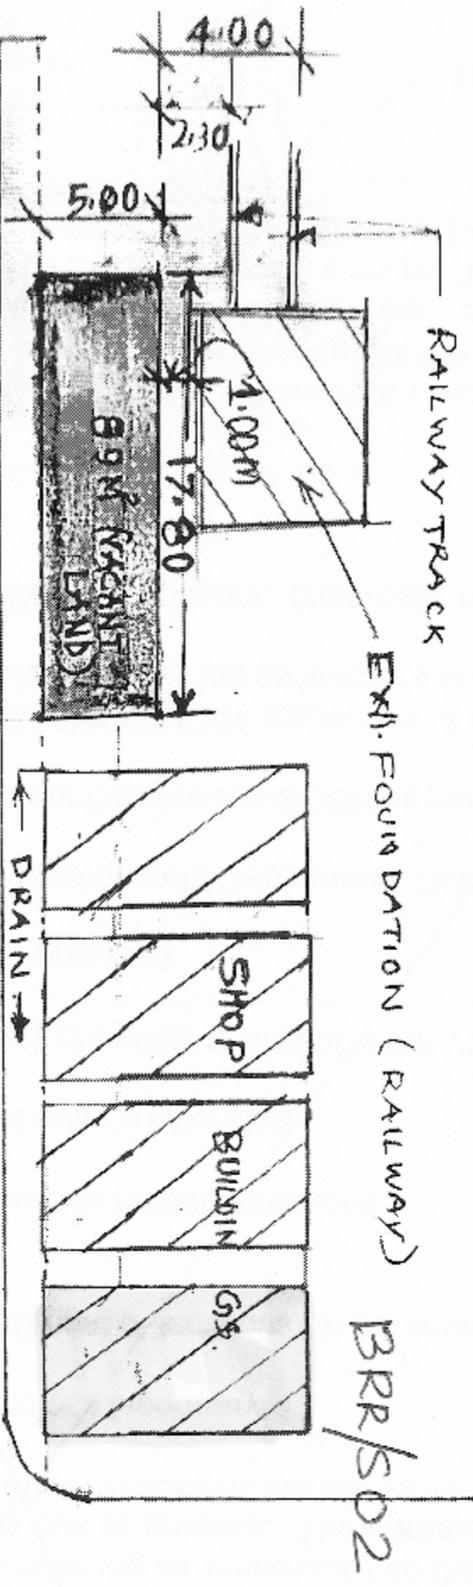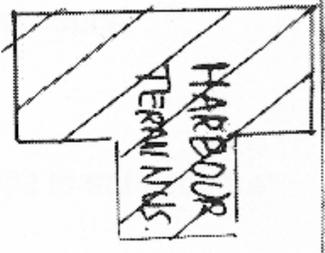

ROAD TO ERANAKULAM

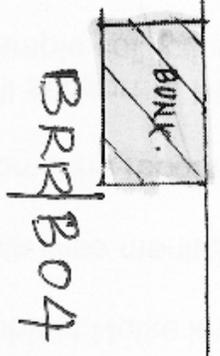

All dimensions in m.
Scale
1:400

TO I.G. ROAD

TO ISLAND

TO Q10 BERTH

HARBOUR TERMINUS JUNCTION,
M. ISLAND.

~~BRR/KEC~~

7



JAIRAM
SONS.

INDIAN
CHAMER
OF COMMERCE

6th CROSS ROAD.

AGI MARK.

M.O
DEVASSY

JASS
PAACK

AJK
ENTER
PRISES

CASINO
HOTEL

NIKIAS

BRB
806

G. V. IYYAR ROAD

DHOLOTA

DHOLOTA

JANNADAS
MADAVI

LEASED
LAND
ZOOM
AGENCIES

AZAD
BUILDING

TRAVANCOR
MAT

CHURCH

SURAF
GODDONS

MOSQUE

MRRB01

K. P. K MENON ROAD


COPT
HOSPITAL

COPT
QTRs.

BRB
807

807

Handwritten scribbles and numbers at the bottom left corner.

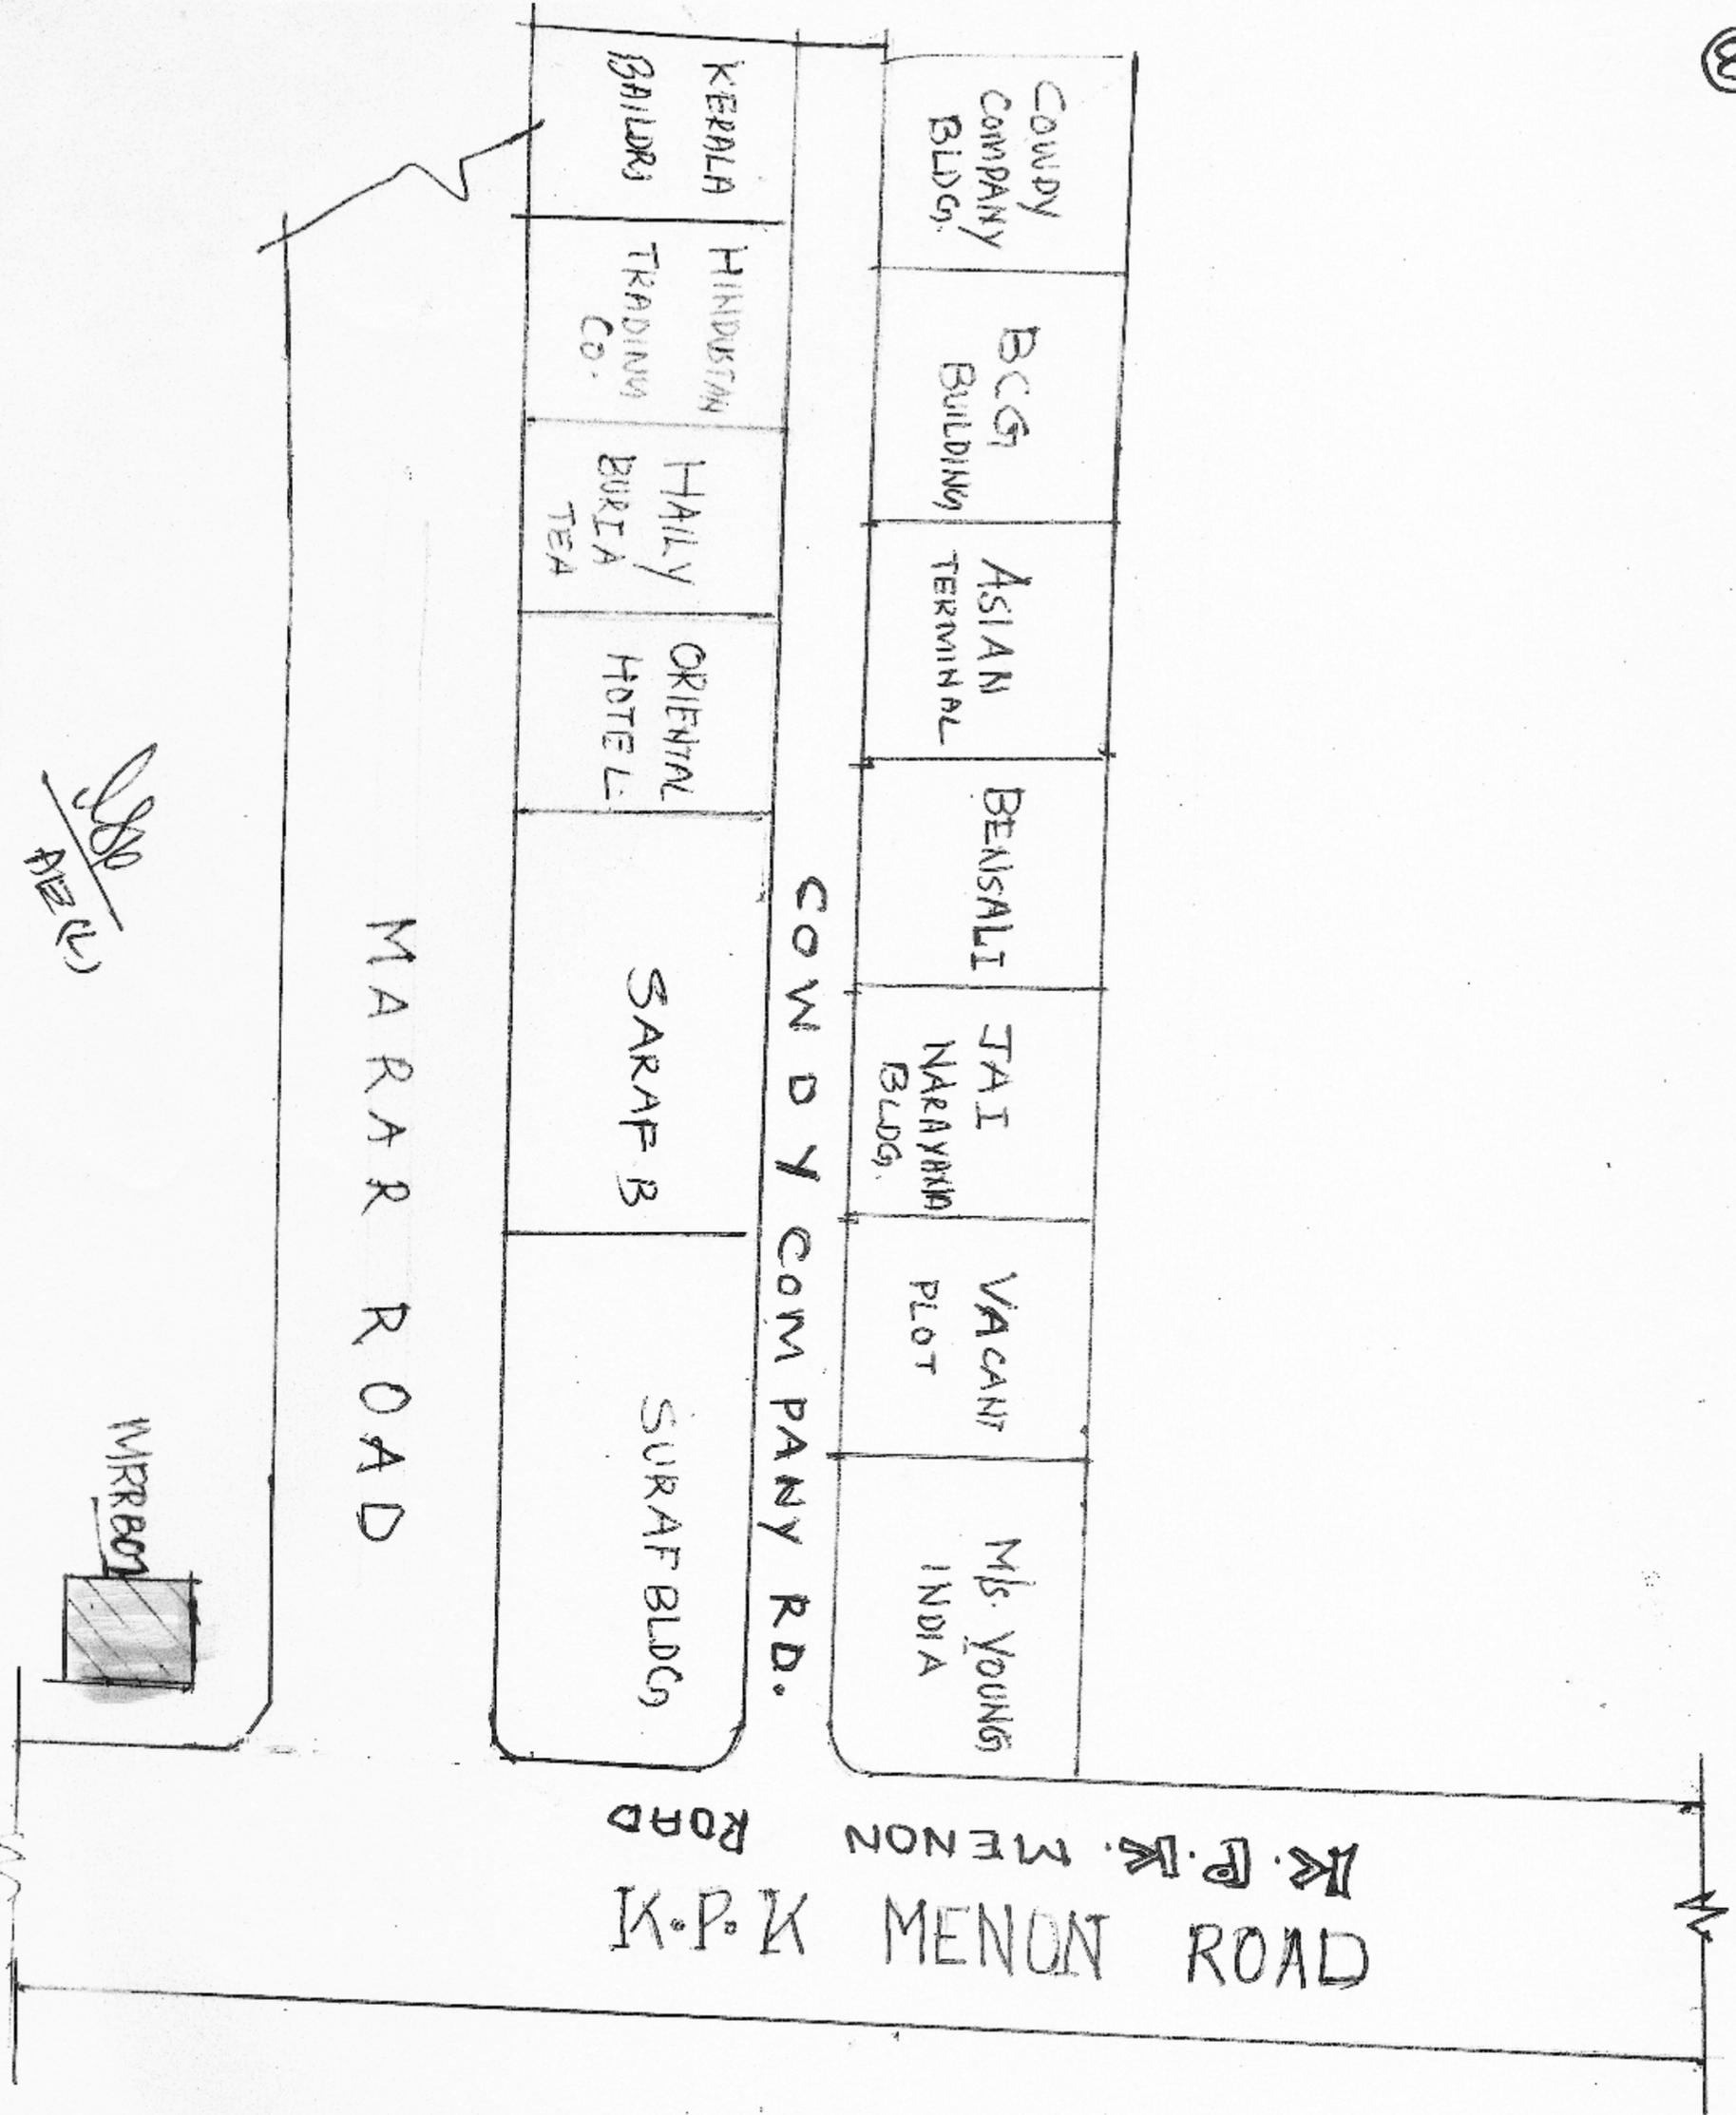


J.P. AIR

MARRAR ROAD

COWDY COMPANY RD.

K.P.K. MENON ROAD





WRRB

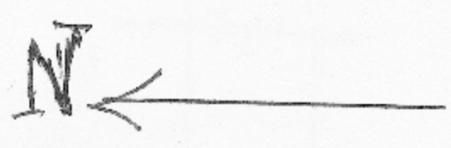

CROSS ROAD

BRISTOW RD.

ARUMUYI BUS STOP

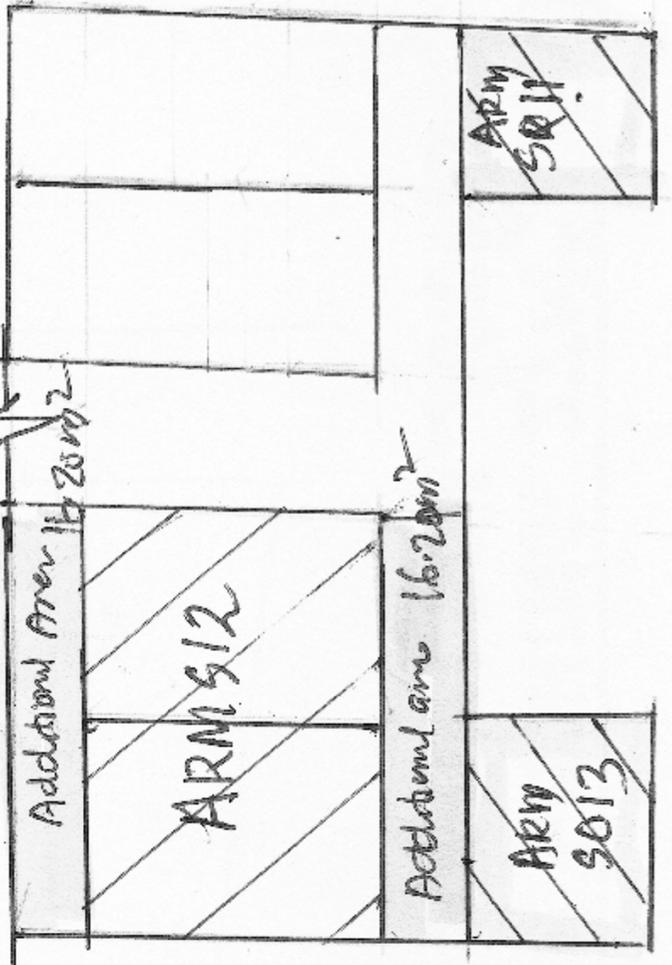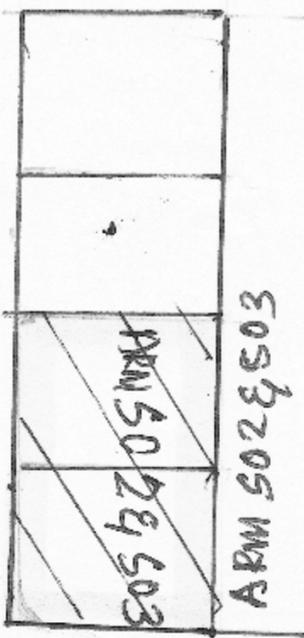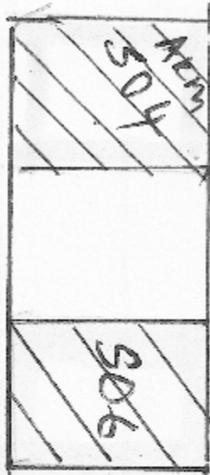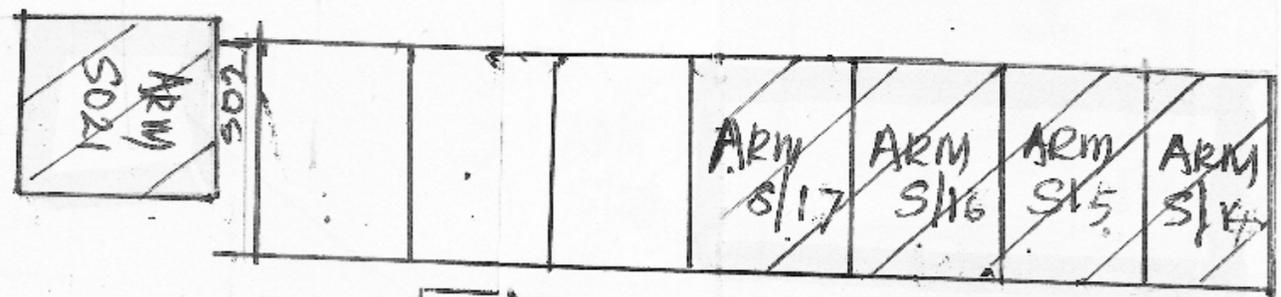


ACCESS

Location sketch
NOT TO SCALE

ARMY S/14

10


20/11/20
20/11/20

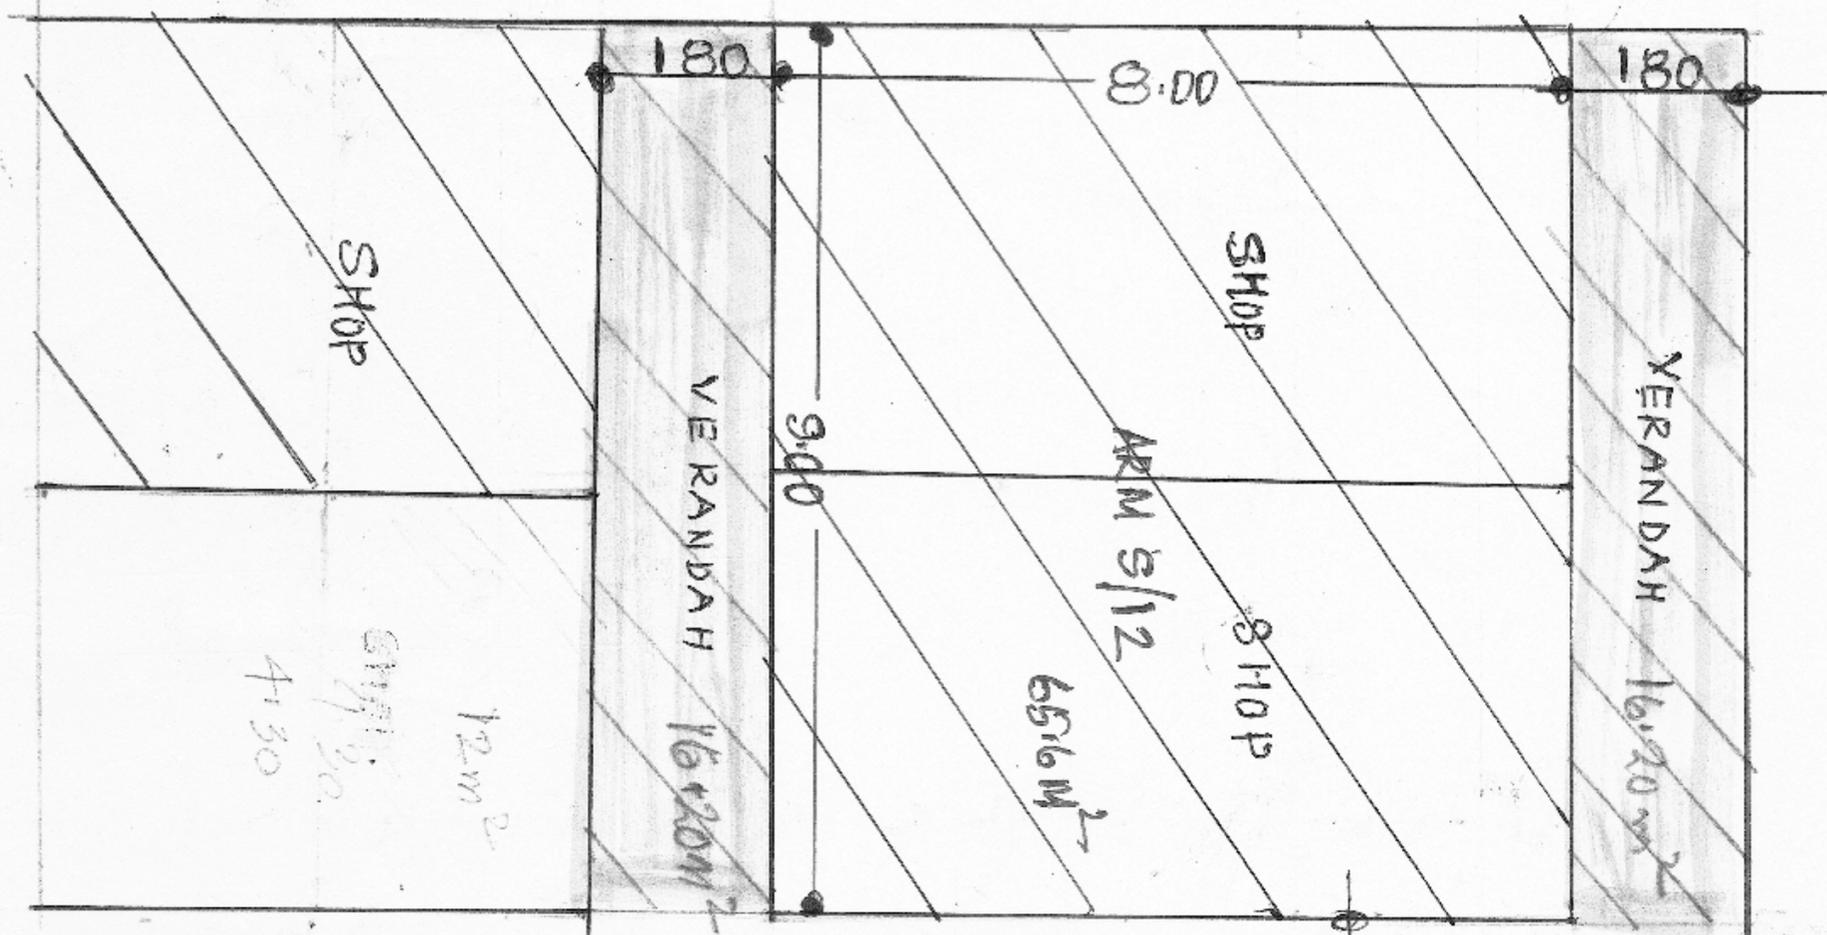

9
N
A
N

SKETCH SHOWING THE SHOP BLDG.
NO. 7 ARM S/12 AT ARUMURTI, TAI-ISLAND.

ALL DIM IN METERS
Scale 1:100

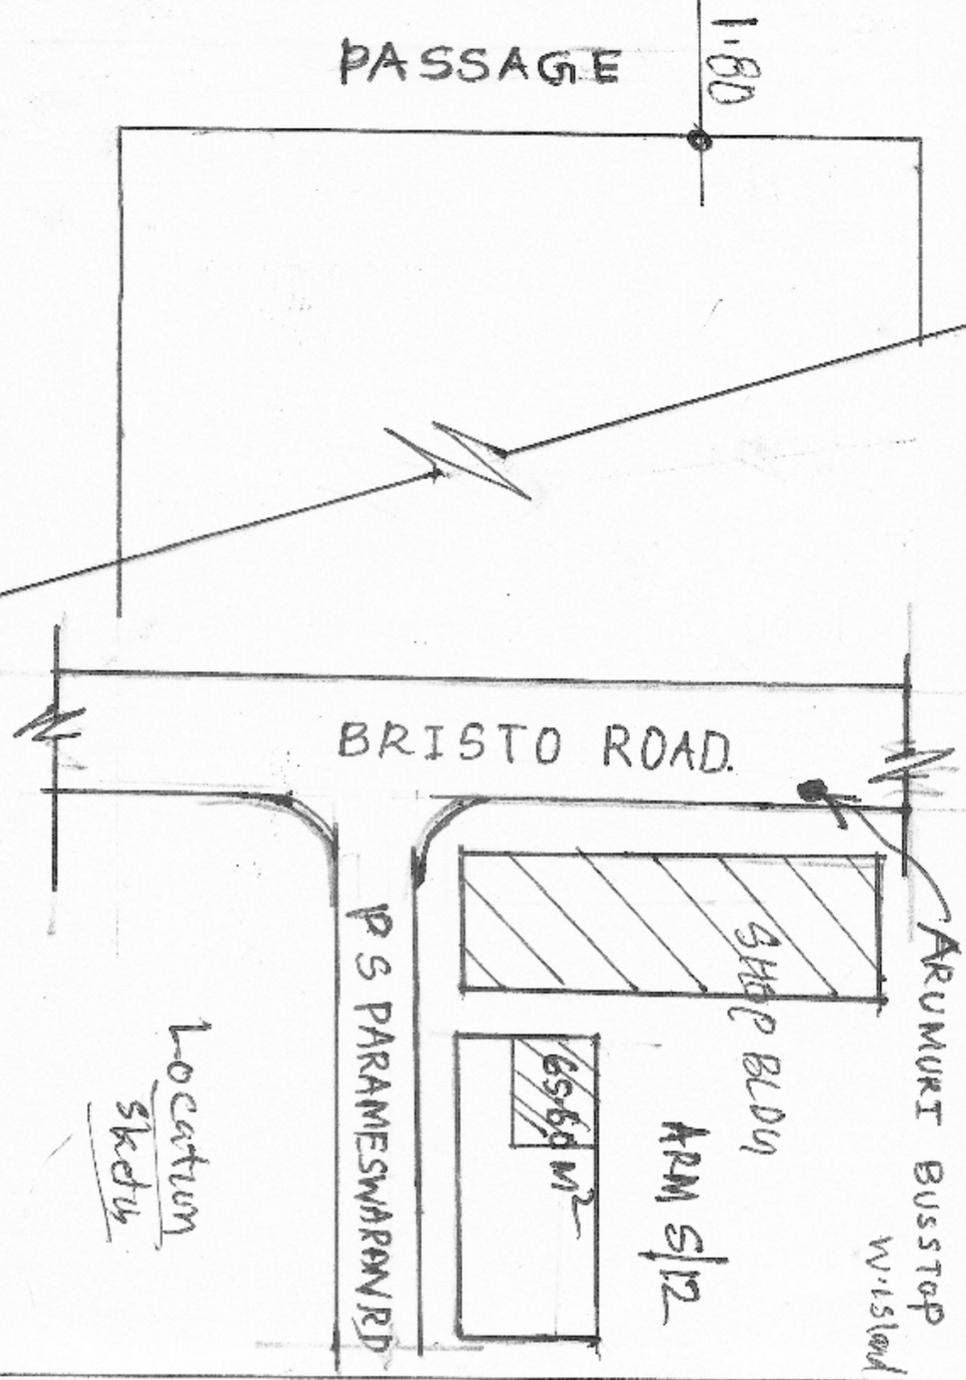


Actual area: 65.60m²
 Additional area: 32m²
 Total: 97.60

Sta 98m²

Location
sketch

③

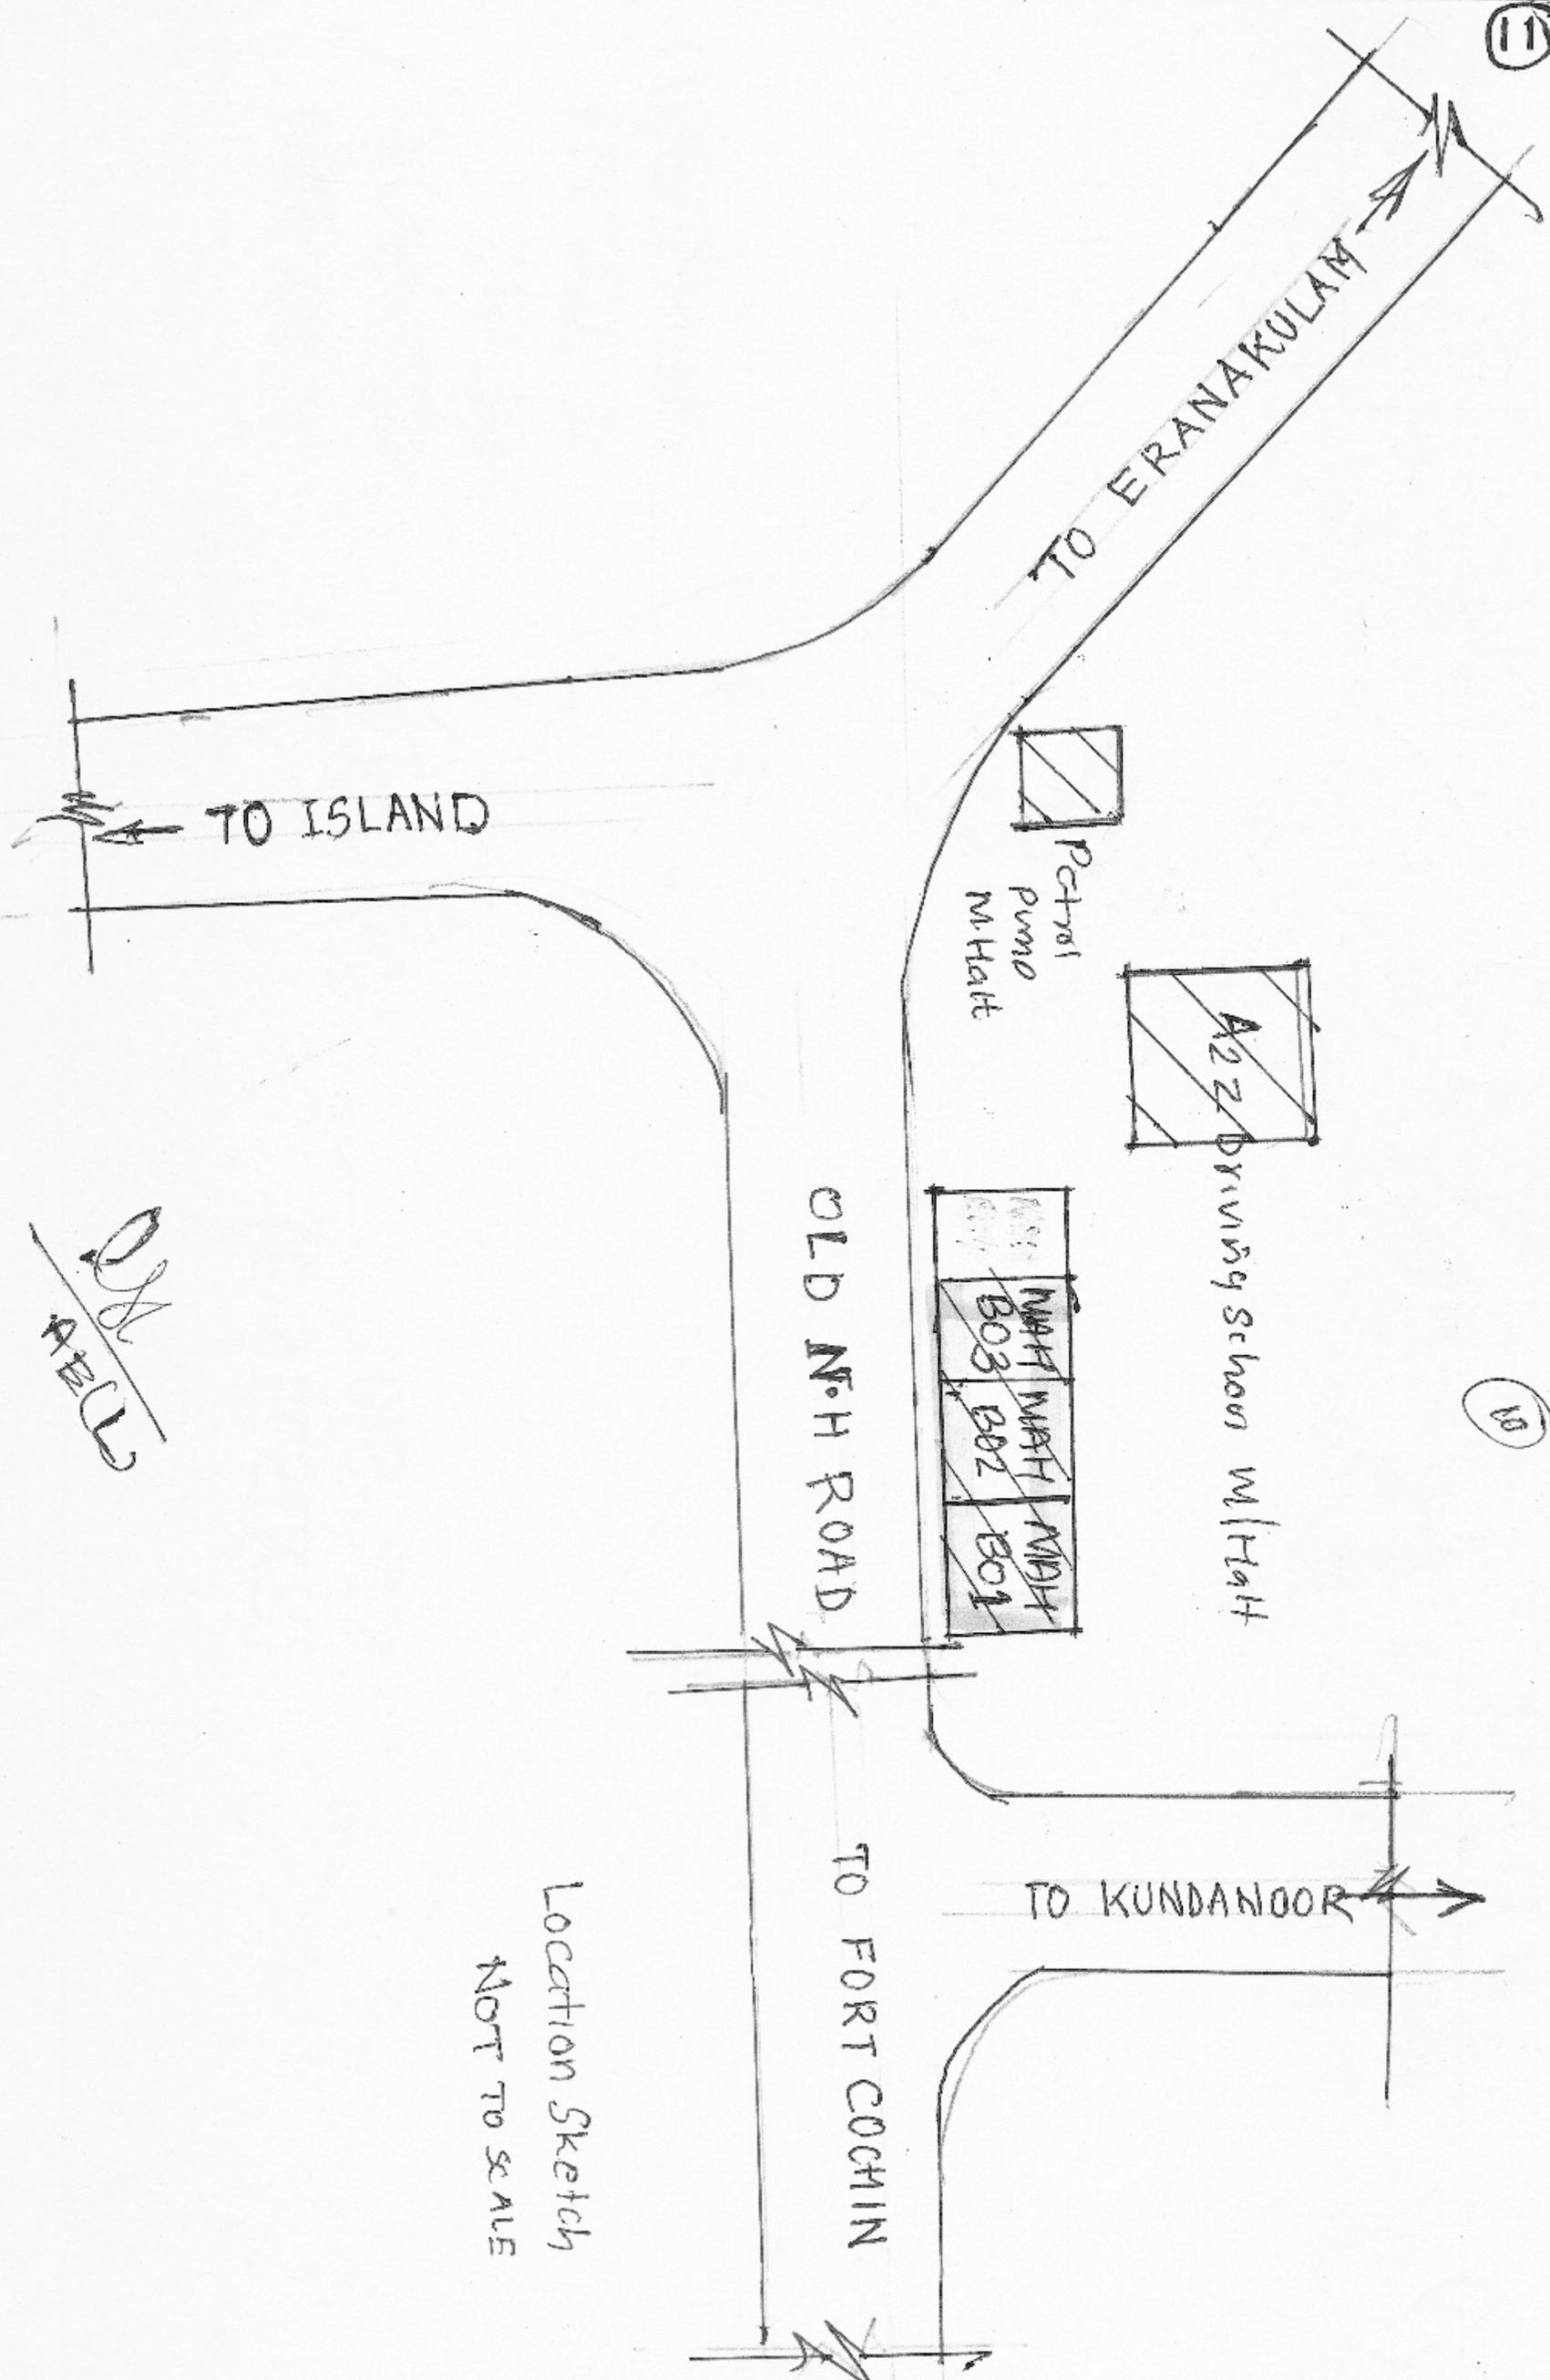

10

Q.A.
RECL

Location Sketch
NOT TO SCALE

location sketch of all
31 bunk/shop please

Bid No.xx/xx-xx/xxxx

27/3/25

9. Format of Price bid

Sl. No	Details of asset	Location	Area in Sq m	Reserve Price of monthly license fee(Excluding GST) in Rs	Monthly license fee offered for the property (Excluding GST) in Rs.
(1)	(2)	(3)	(4)	(5)	(6)
1	MLR B/01(bunk)	Near North end Gents Hostel	3.75	1219	Hanuman ✓
2	MLR B/06(bunk)	E.W gate	3.75	1219	Kothiker ✓
3	MLR B/08(bunk)	E.W gate	3.75	1219	Crown ✓
4	MLR B/10(bunk)	E.W gate	4.5	1463	Raj ✓
5	MLR B/11(Bunk)	E.W gate	4.5	1463	Ramesh ✓
6	MLR S/02(Shop)	Near Port Guest House	10	622	Krishna ✓
7	MLR S/03(Shop)	Near Port Guest House	10	622	Ali ✓
8	IGR B/02(Bunk)	Near CHHA	8	2600	Sudhan ✓
9	IGR B/07(Bunk)	Near DLD bldg	3.75	1219	Munish ✓
10	BRR B/01(shop)	5 th cross road, Near Tata Tea Ltd	9.5	591	Beer ✓
11	BRR B/02(bunk)	6 th cross road near AE(CZ) Office	3.75	1219	42 Suresh ✓
12	BRR B/03(bunk)	Opp.Indian Chamber Bldg.	3.75	1219	Noushad ✓
13	BRR B/04(Bunk)	Near Harbour Police Station	8.66	2815	Thoms ✓
14	BRR B/06(bunk)	Near Church	3.75	1219	Roster ✓
15	BRR B/07(Bunk)	Near Port Hospital	6.25	2032	43 Abdul ✓
16	BRR S/02(Shop)	CHTS	29	1804	Sheep ✓
17	MRR B/01(bunk)	Near Sanitary Section	3.75	1219	Bud ✓
18	ARM S/02&S/03(shop)	Armouri Shop.Complx.	9.5+9.5	1182	Tom ✓
19	ARM S/04(Shop)	Armouri Shop.Complx.	15	933	Shay ✓
20	ARM S/06(Shop)	Armouri Shop.Complx.	17.5	1089	Pr ✓
21	ARM S/11(Shop)	Armouri Shop.Complx.	10	622	Sud ✓
22	ARM S/12(shop)	Armouri Shop.Complx.	65.6	4079	Sad ✓

one sketch
two ch floor

Submitted the above sketch on 01/04/2025